


As-Built Floor Plan

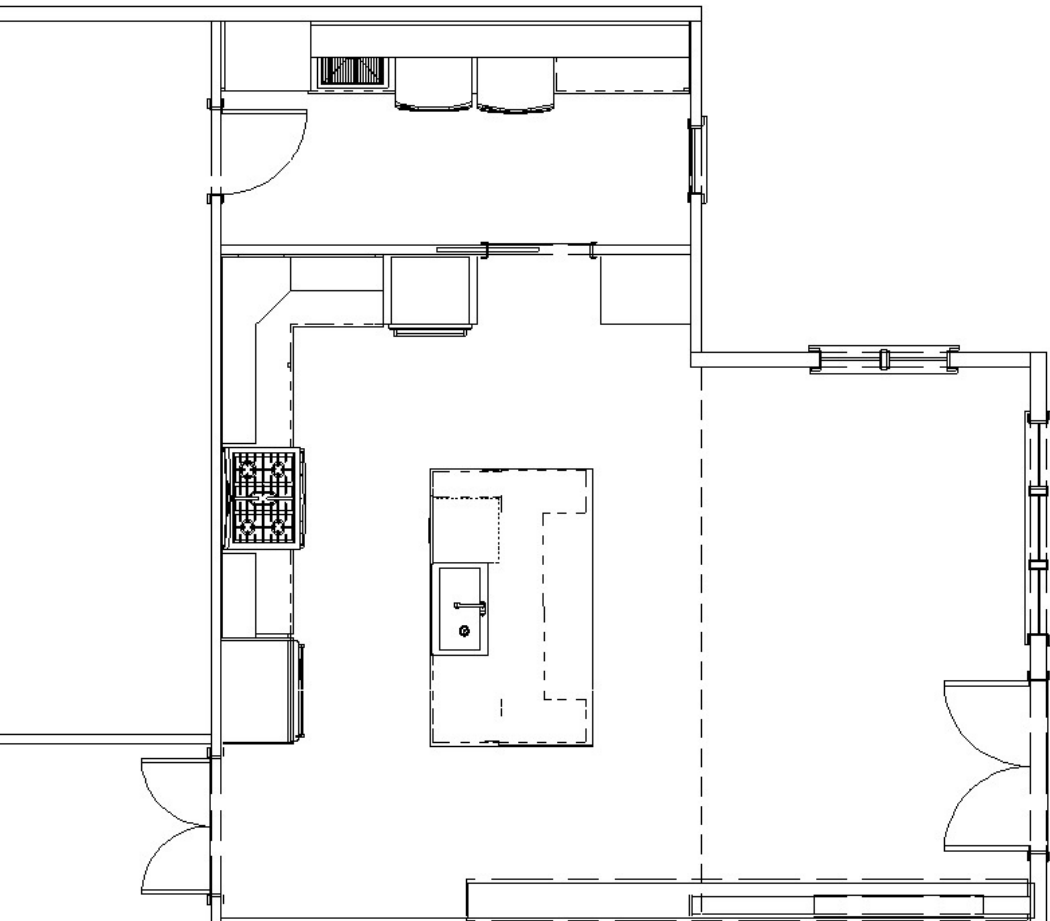

**After Floorplan**