


As Built Floor Plan



After Floor Plan

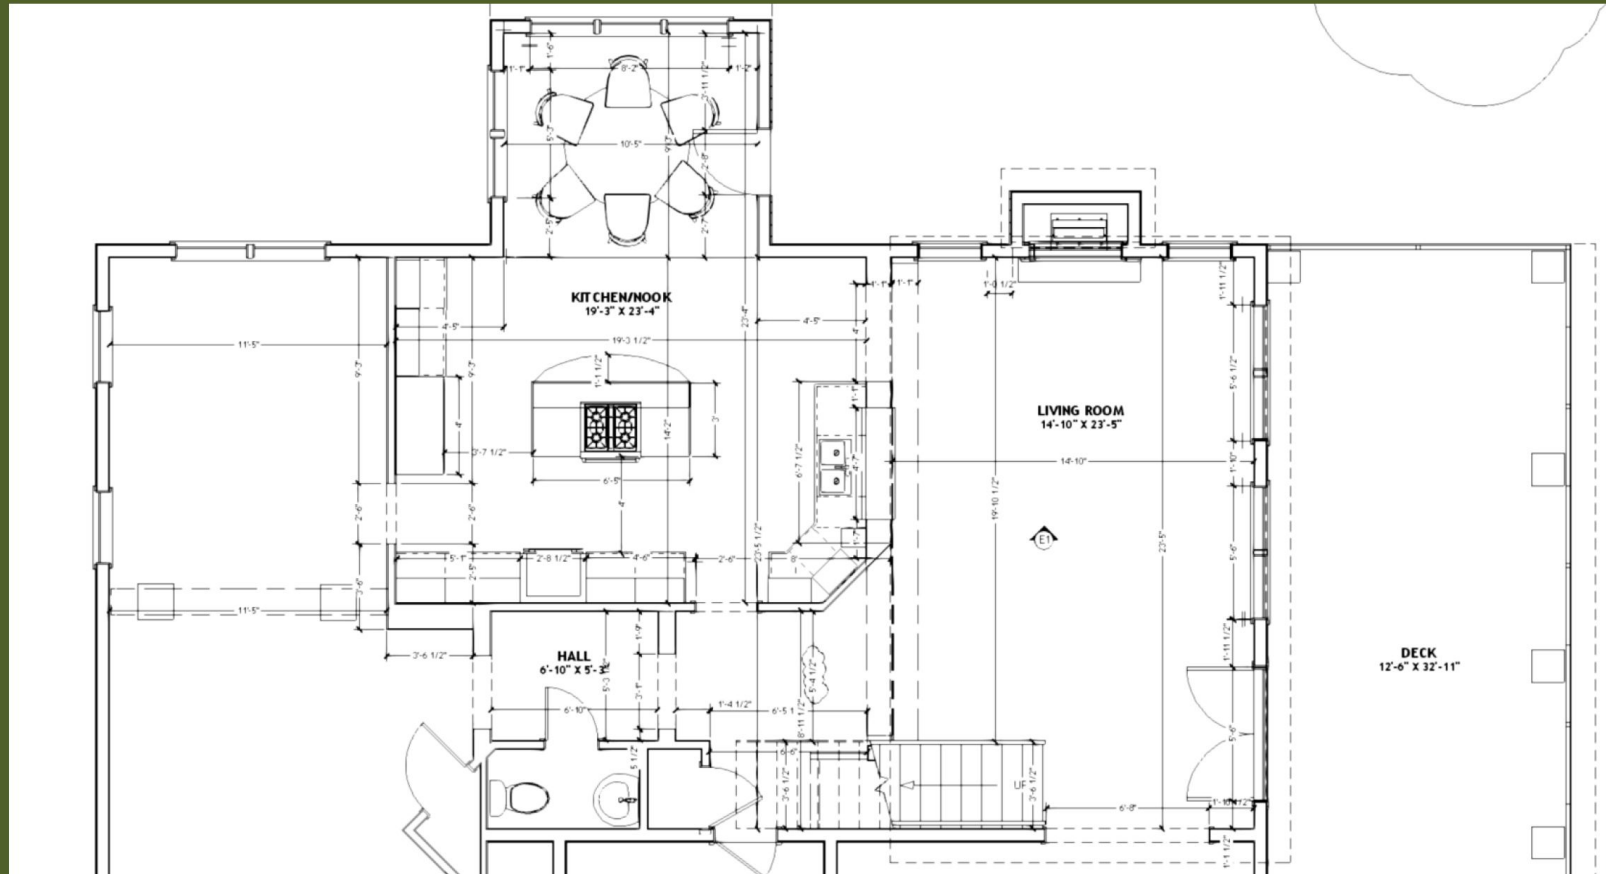